
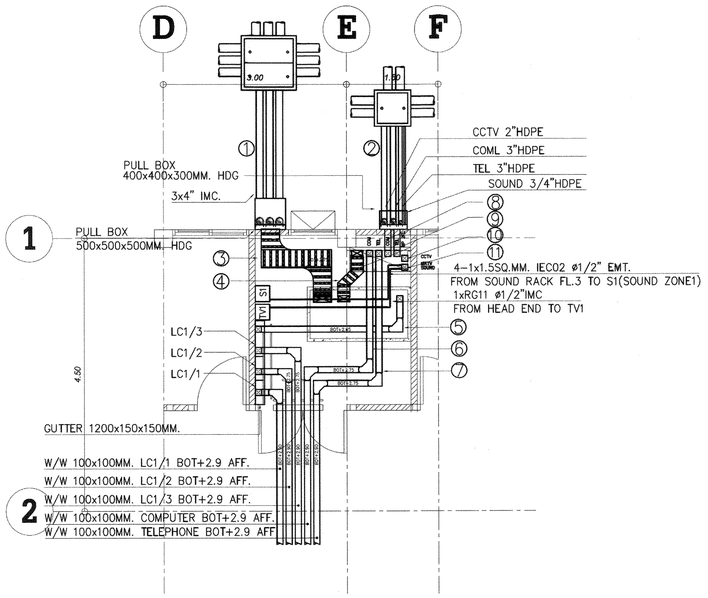



DETAIL EE ROOM 1 FL.

SCALE 1:50

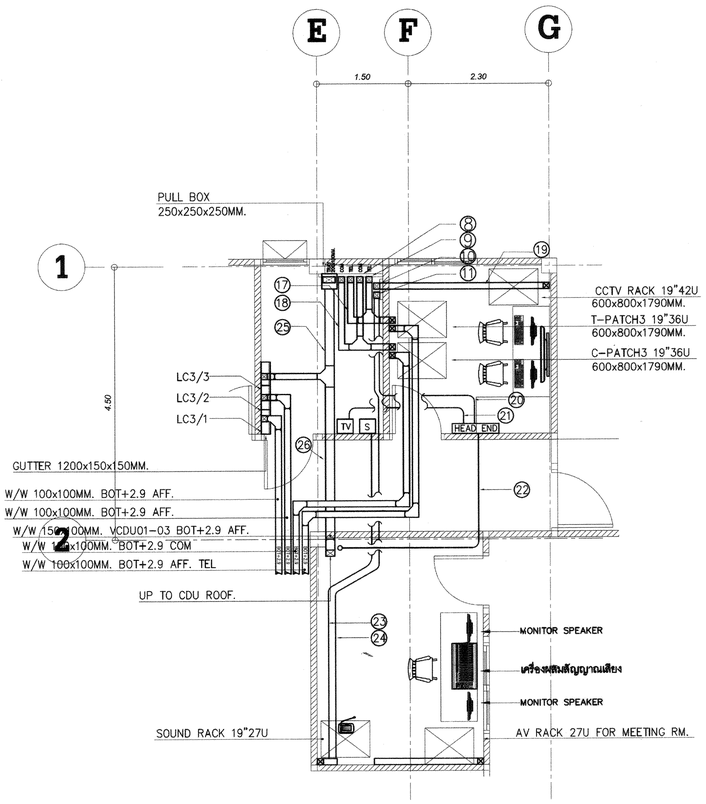

DETAIL EE ROOM 3 FL.

SCALE 1:50

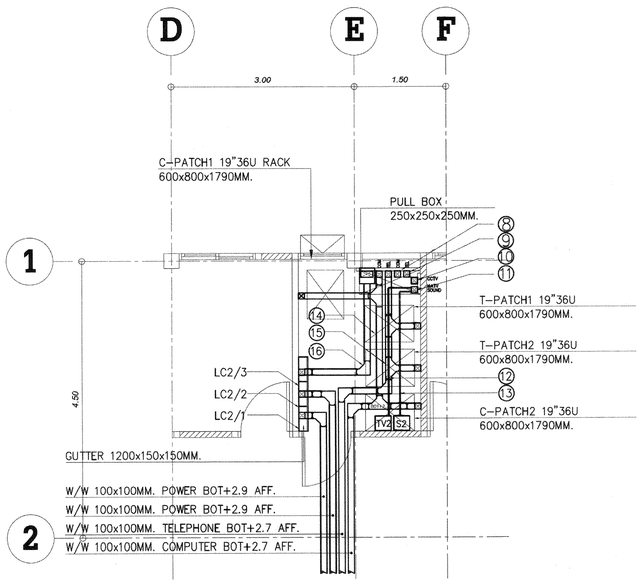

DETAIL EE ROOM 2 FL.

SCALE 1:50

NOTE

① SPARE 3xø4" IMC. CONDUIT BY OTHERS FOR MAIN MDB
② SPARE 1xø3" IMC. CONDUIT BY OTHERS FOR COMPUTER
SPARE 1xø3" IMC. CONDUIT BY OTHERS FOR TELEPHONE
SPARE 1xø2" IMC. CONDUIT BY OTHERS FOR CCTV
SPARE 1xø3/4" IMC. CONDUIT BY OTHERS FOR SOUND
③ SPARE 300x100MM. CABLE TRAY FOR EGAT IN CABLE TRAY 200x100MM.
④ 4-10/4G.SQ.MM.IEC01.FROM MDB TO LC2/1 FL.2
4-10/4G.SQ.MM.IEC01.FROM MDB TO LC2/2 FL.2
4-16/6G.SQ.MM.IEC01.FROM MDB TO LC2/3 FL.2
4-10/4G.SQ.MM.IEC01.FROM MDB TO LC3/1 FL.3
4-10/4G.SQ.MM.IEC01.FROM MDB TO LC3/2 FL.3
4-16/6G.SQ.MM.IEC01.FROM MDB TO LC3/3 FL.3
4-50/10G.SQ.MM.IEC01.FROM MDB TO CB.1 (ROOF)
4-50/10G.SQ.MM.IEC01.FROM MDB TO CB.2 (ROOF)
4-70/16G.SQ.MM.IEC01.FROM MDB TO CB.3 (ROOF)
} IN CABLE TRAY 200x100MM.
⑤ 4-10/4G.SQ.MM.IEC01.FROM MDB TO LC1/1
4-10/4G.SQ.MM.IEC01.FROM MDB TO LC1/2
4-35/10G.SQ.MM.IEC01.FROM MDB TO LC1/3
} IN WIRE WAY 100x100MM.
⑥ BRANCH FOR COMPUTER OUTLET FL.1 TO C-PATCH1 FL.2 IN WAY WAY 100x100MM.
⑦ BRANCH FOR TELEPHONE OUTLET FL.1 TO T-PATCH1 FL.2 IN WAY WAY 100x100MM.
⑧ SPARE 100x100MM.WIRE WAY BY OTHERS FOR COMPUTER
⑨ SPARE 100x100MM.WIRE WAY BY OTHERS FOR TELEPHONE
⑩ SPARE 100x100MM.WIRE WAY BY OTHERS FOR CCTV
⑪ SPARE 100x100MM.WIRE WAY BY OTHERS FOR SOUND

NOTE

⑫ 1xRG11.IN ø1/2" EMT. FROM FROM HEAD END TO TV2
⑬ 4-1.5SQ.MM. IEC02 ø1/2" EMT. FROM SOUND RACK FL.3 TO S2(SOUND ZONE2)
⑭ UTP CAT6 FOR COMPUTER OUTLET FL.1 TO C-PATCH1 FL.2
24C-FIBER OPTIC SM FROM C-PATCH1 FL.2 TO C-PATCH3 FL.3
24C-FIBER OPTIC SM FROM C-PATCH2 FL.2 TO C-PATCH3 FL.3
} IN WIRE WAY 100X100 MM.
⑮ UTP CAT6 FOR TELEPHONE OUTLET FL.1 TO T-PATCH1 FL.2
2(25P-0.65SQ.MM.)TPEV FROM T-PATCH1 FL.2 TO T-PATCH3 FL.3
2(25P-0.65SQ.MM.)TPEV FROM T-PATCH2 FL.2 TO T-PATCH3 FL.3
} IN WIRE WAY 100X100 MM.
⑯ 4-10/4G.SQ.MM.IEC01.FROM MDB TO LC2/1 FL.2
4-10/4G.SQ.MM.IEC01.FROM MDB TO LC2/2 FL.2
4-16/6G.SQ.MM.IEC01.FROM MDB TO LC2/3 FL.2
} IN WIRE WAY 100X100 MM.
⑰ 2(25P-0.65SQ.MM.)TPEV FROM T-PATCH1 FL.2 TO T-PATCH3 FL.3
2(25P-0.65SQ.MM.)TPEV FROM T-PATCH2 FL.2 TO T-PATCH3 FL.3
} IN WIRE WAY 100X100 MM.
⑱ 24C-FIBER OPTIC SM FROM C-PATCH1 FL.2 TO C-PATCH3 FL.3
24C-FIBER OPTIC SM FROM C-PATCH2 FL.2 TO C-PATCH3 FL.3
} IN WIRE WAY 100X100 MM.
⑲ SPARE 100x100MM.WIRE WAY BY OTHERS FOR CCTV
⑳ 2-RG11.IN ø3/4" EMT.FROM HEAD END TO TV1,TV2
㉑ 1-RG11.IN ø3/4" EMT.FROM HEAD END TO TV3
㉒ 1-RG11.IN ø3/4" IMC.FROM ANTENNA TO HEAD END
㉓ 2(4-1.5SQ.MM. IEC02) ø3/4" EMT. FROM SOUND RACK FL.3 TO S1,2(SOUND ZONE1,2)
㉔ 4-1.5SQ.MM. IEC02 ø1/2" EMT. FROM SOUND RACK FL.3 TO S3(SOUND ZONE3)
㉕ 4-10/4G.SQ.MM.IEC01.FROM MDB TO LC3/1
4-10/4G.SQ.MM.IEC01.FROM MDB TO LC3/2
4-16/6G.SQ.MM.IEC01.FROM MDB TO LC3/3
4-50/10G.SQ.MM.IEC01.FROM MDB TO CB.1 (ROOF)
4-50/10G.SQ.MM.IEC01.FROM MDB TO CB.2 (ROOF)
4-70/16G.SQ.MM.IEC01.FROM MDB TO CB.3 (ROOF)
} IN WIRE WAY 150x100MM.
㉖ 4-50/10G.SQ.MM.IEC01.FROM MDB TO CB.1 (ROOF)
4-50/10G.SQ.MM.IEC01.FROM MDB TO CB.2 (ROOF)
4-70/16G.SQ.MM.IEC01.FROM MDB TO CB.3 (ROOF)
} IN WIRE WAY 150x100MM.

การไฟฟ้าฝ่ายผลิตแห่งประเทศไทย
ฝ่ายออกแบบและบริหารงานก่อสร้าง
ได้รับการรับรอง ISO 9001:2008
53 หมู่ 2 ถนนจรัญสนิทวงศ์ บางกรวย นนทบุรี 11130 โทร436-1910-3

งานออกแบบ และ เอกสารประกอบแบบถือเป็นสมบัติของ
ฝ่ายออกแบบและบริหารงานก่อสร้าง การไฟฟ้าฝ่ายผลิตแห่งประเทศไทย
ห้ามผู้ใดนำไปใช้งาน ทำซ้ำ หรือ ดัดแปลง โดยไม่ได้รับอนุญาตเป็น
ลายลักษณ์อักษร จาก การไฟฟ้าฝ่ายผลิตแห่งประเทศไทย

ออกแบบ
สถาปนิก (นาย อดิศร ศรีสุพรรณ)
สถาปนิกภายใน (นางสาวศานลิวร เอื้อประเสริฐ)
(นาย อภิสิทธิ์ ณิฐวรวโรหน์)
วิศวกรโครงสร้าง (นาย ทรงคุณ วิชินไรจน์จร)
(นาย กานต์เดช ปั้นเจริญ)
วิศวกรสุขาภิบาล (นาย วัชระ สมโรจน์รัตน์)
วิศวกรไฟฟ้า (นาย ประพัทธ์ ชื่นชุมศรี)
วิศวกรเครื่องกล (นาย ลูกยุทธ์ จำปาทนม์)

ตรวจสอบ
ผู้ควบคุมงาน กฟผ. (นาย บุญชัย ผดุงสมบัติถาวร)
(นาย ดนุพงษ์ สรรพดุคม)
(นาย อภิศักดิ์ ร่าพึงกิจ)
(นาย นนทชัย สกุลรัตน์ไพศาล)
หัวหน้าแผนกบริหารสัญญาก่อสร้างอาคาร (นาย ศรชัย อภิบาลพลธรรม)

เห็นชอบ
(นาย สโรจน์ จีนโก้ว)
หัวหน้ากองบริหารงานก่อสร้าง

ผู้รับจ้าง

CAN DO CONSTRUCTION CO.,LTD
222 ถนนเทศบาลรังรักษ์เหนือ แขวงลาดยาว
เขตจตุจักร กรุงเทพมหานคร 10900
TEL. 591-3972 , 591-4906 FAX. 954-3759

เขียนแบบ (นาย สุธีรพันธ์ ภู่ไหม)
ตรวจสอบ (นาย ทศพร จันทร์สน)
รับรอง (นาย สำราญ เจริญวงศ์)
วิศวกรโครงการ

AS-BUILT DRAWING

งานอาคารสำนักงาน (อชน.)

แบบแสดง
ELECTRICAL ROOM 1-3 FLOOR

อ้างอิงแบบ กฟผ. เลขที่	แบบเลขที่
-	AB-SNO-OF12-05-E-30/30
เลขที่งาน	จำนวนแผ่น
257112-4	30